


PARTIAL FLOOR PLAN

SCALE: 1/8" = 1'-0"

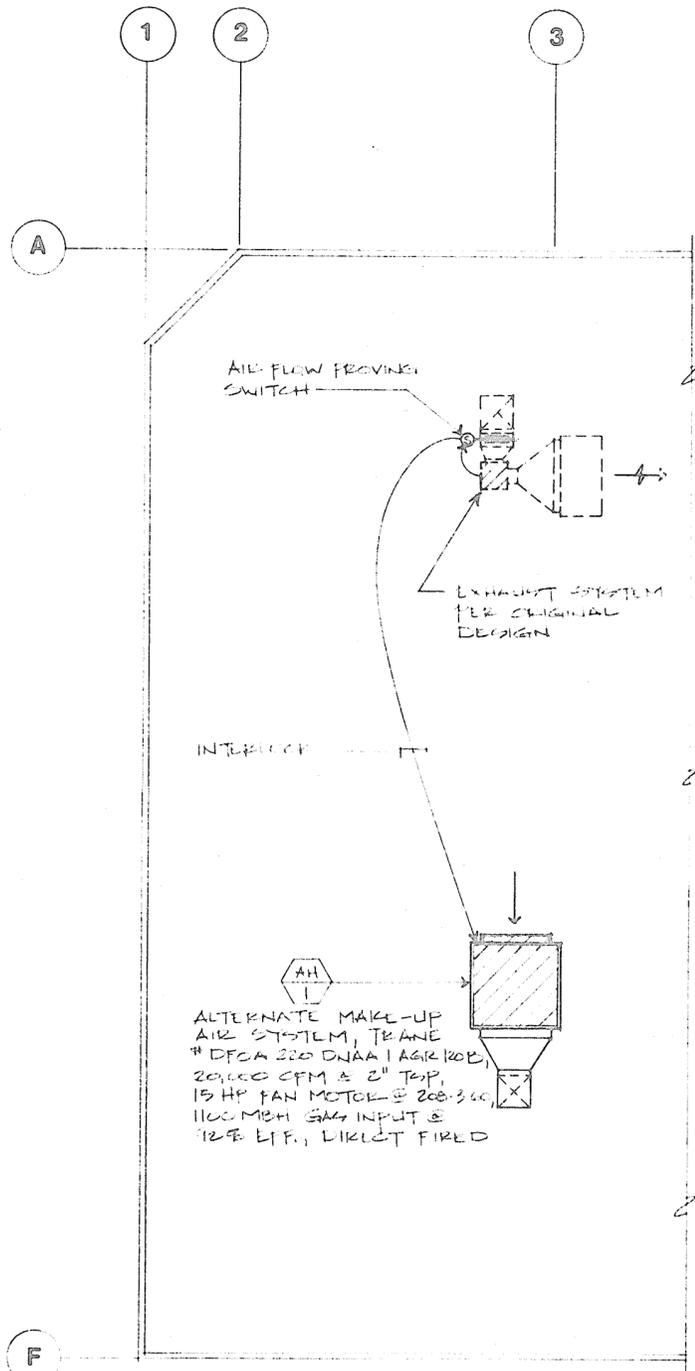

PARTIAL ROOF PLAN

SCALE: 1/8" = 1'-0"



- Plan Check Notes**
- The effects of this alternate design upon the mechanical scope of work are listed as follows:
    - The original design utilized a rooftop air handling unit (AHU-1) containing a hot water heating coil, boiler (B-1) pump and circulation piping to provide make-up air to the gun range.
    - The alternate design will instead utilize a packaged rooftop direct gas fired air handling unit (AHU-1) to provide make-up air to the gun range.
  - The effects of this alternate design upon the mechanical Energy Efficiency Standards compliance forms are listed as follows:
    - MECA-1 Part 1 of 3 (Certificate of Compliance) No change.
    - MECA-1 Part 2 of 3 (Certificate of Compliance) Previous system (B-1 omitted system AHU-1 revised see attached supplemental form.
    - MECA-1 Part 3 of 3 (Certificate of Compliance) Ignore reference to Pipe Insulation, Boiler and piping omitted.
    - MECA-2 Mechanical Sizing and Fan Power No change. Loads remain the same.
    - MECA-3 Mechanical Equipment Summary See attached supplemental form.
    - MECA-4 Mechanical Ventilation No change. Ventilation remains the same.

**CERTIFICATE OF COMPLIANCE**

PROJECT: ACCURACY GUN DATE: 5-19-94

MECHANICAL SYSTEM	COMPLIANCE	STATUS	DATE
MECA-1 PART 1	MECA-1 PART 1	COMPLIANT	
MECA-1 PART 2	MECA-1 PART 2	COMPLIANT	
MECA-1 PART 3	MECA-1 PART 3	COMPLIANT	
MECA-2	MECA-2	COMPLIANT	
MECA-3	MECA-3	COMPLIANT	
MECA-4	MECA-4	COMPLIANT	

**MECHANICAL EQUIPMENT SUMMARY**

PROJECT: ACCURACY GUN DATE: 5-19-94

SYSTEM	MAKE AND MODEL NO.	DESIGN CAPACITY	STATUS	REMARKS
AH-1	TRANE	1,000,000	NEW	



MECHANICAL CONTRACTOR  
A.O. Reed & Co.  
10711 Hubbard St., Oakland, CA 94643  
(415) 861-1111

ACCURACY GUN  
ALTERNATE AIR - DESIGN

EST. # 50-26740

ADD-70 1104820-94

SHEET NO. M-1A

DATE: 5-19-94

REVISION RECORD

NO.	DATE	BY	REVISION
1			
2			
3			
